
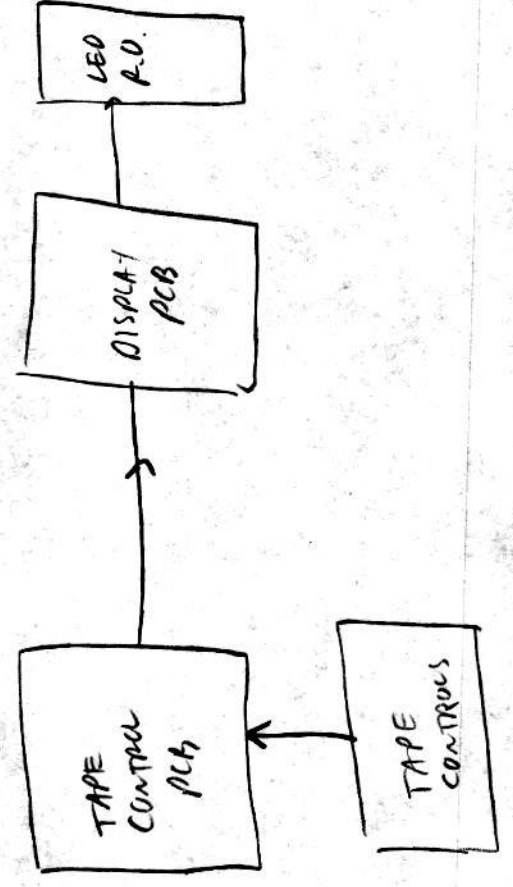
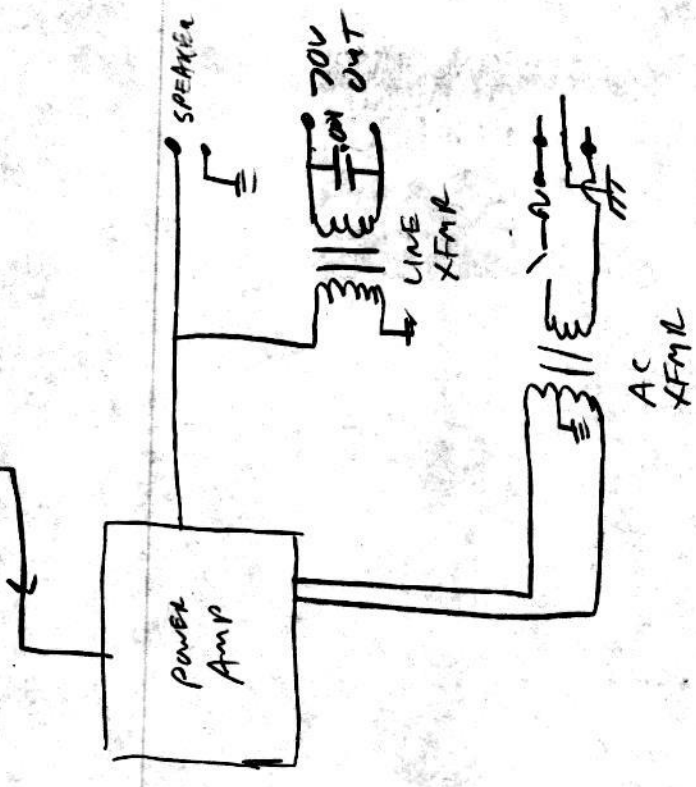


HEADS

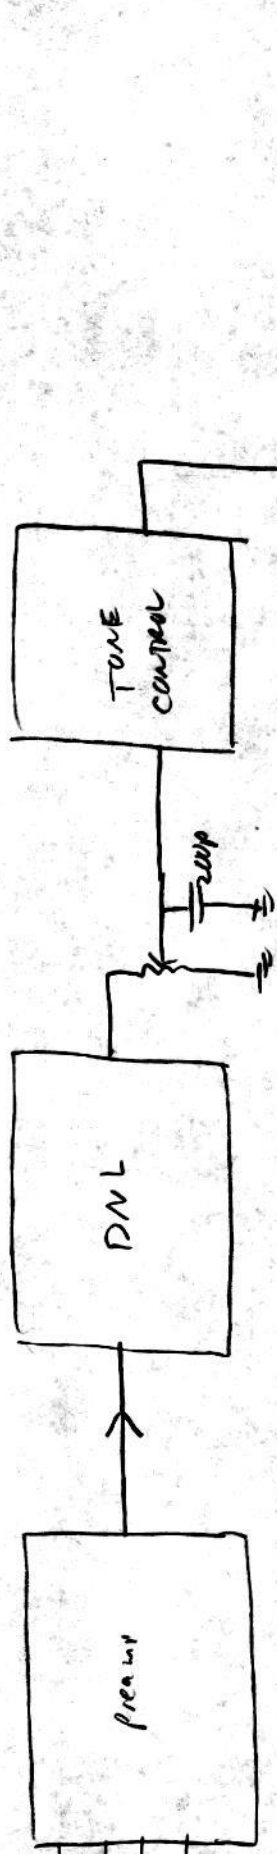


7-8-95


DA

4 Grand Holodeck V.0


Preamplifier

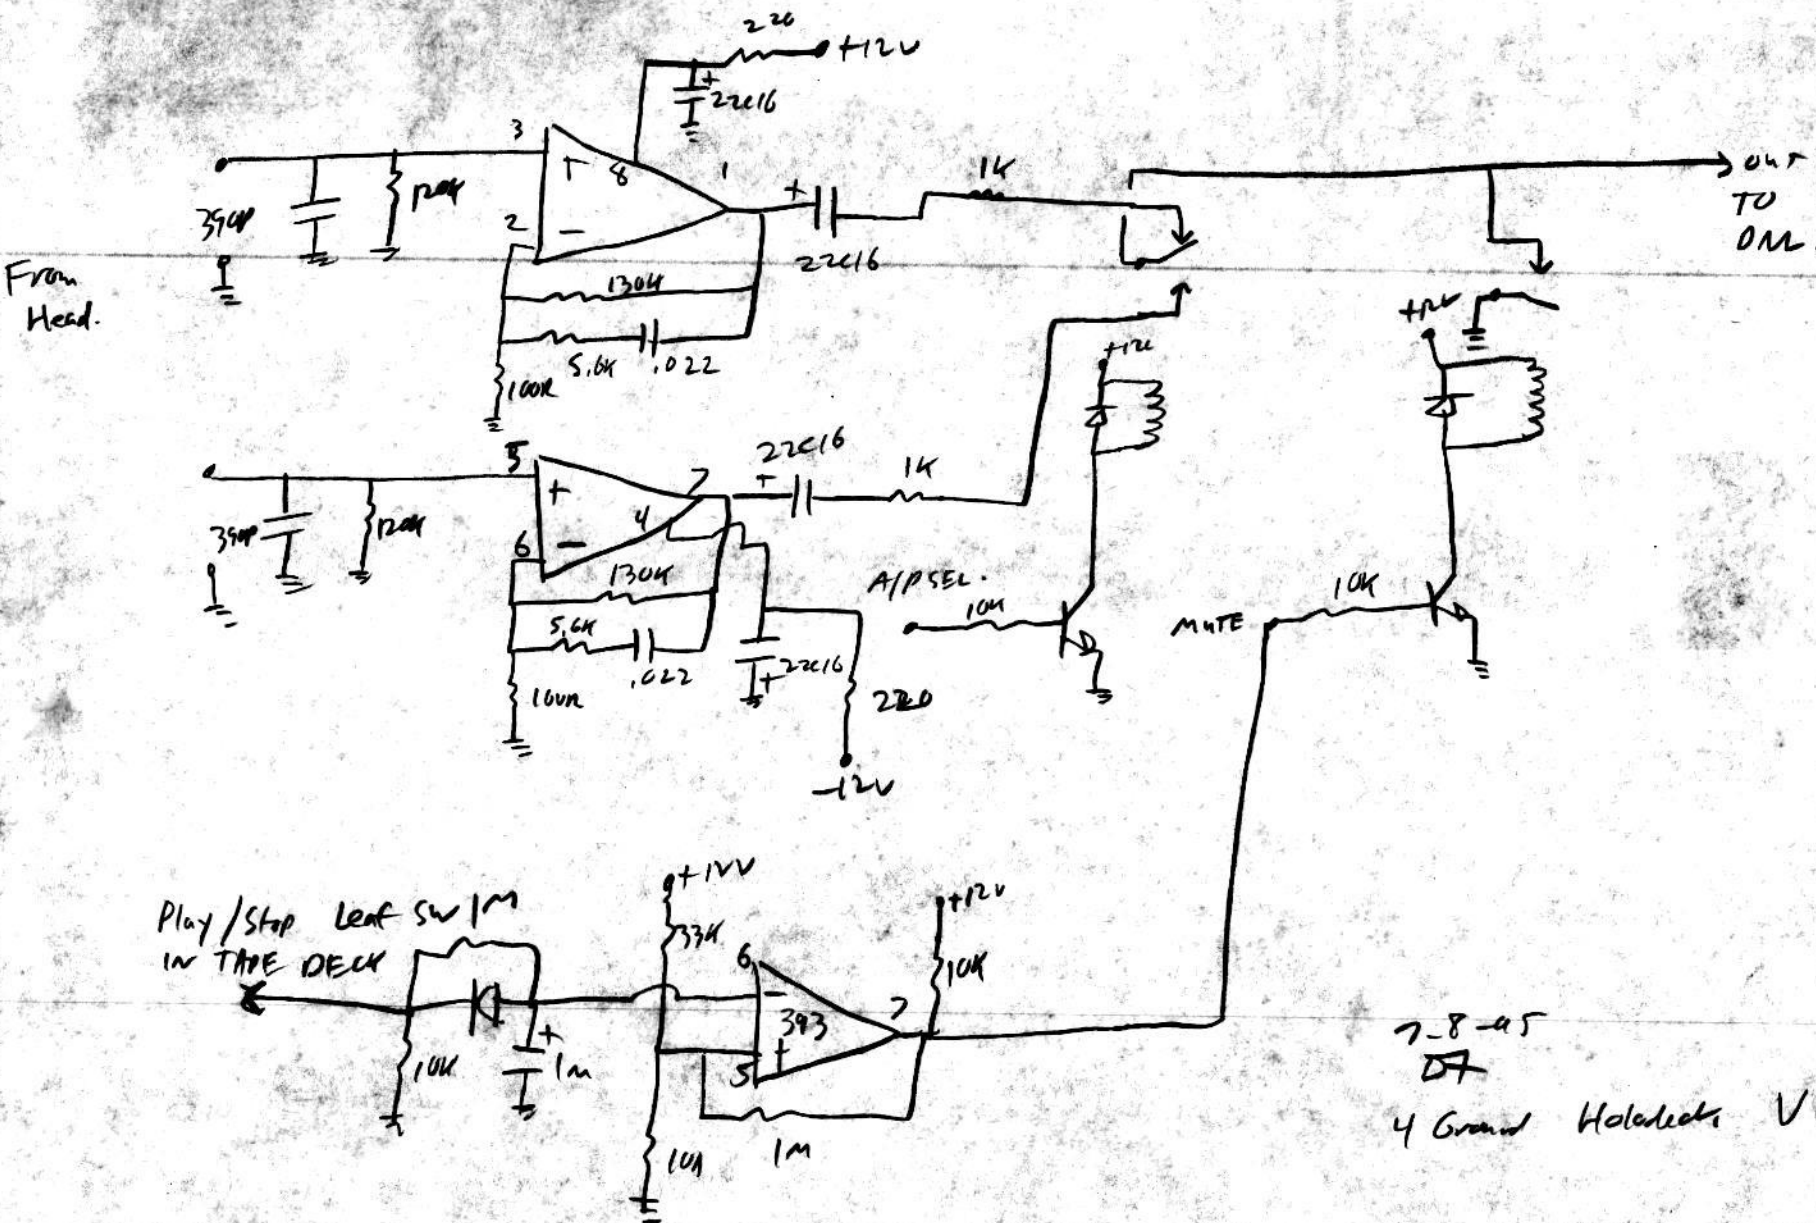

Dynamic Noise Limiter

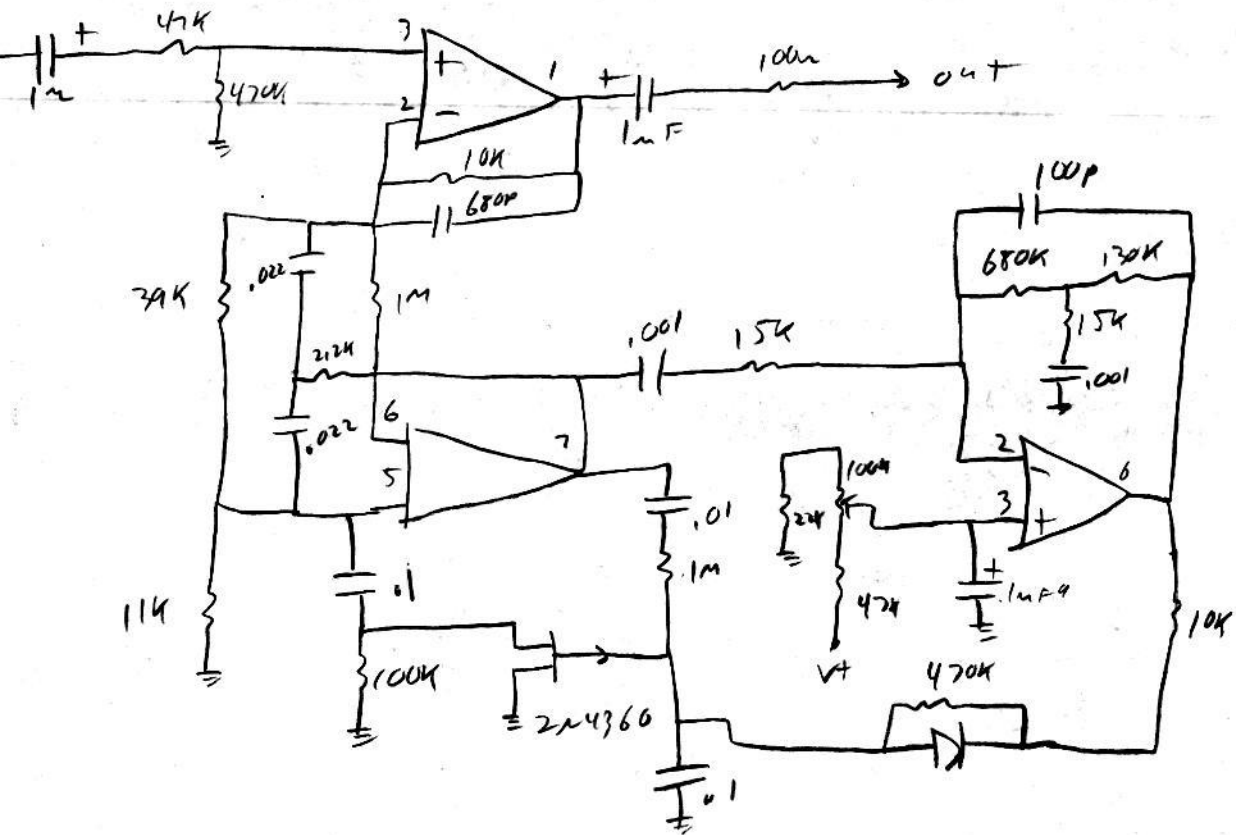

Power Amp

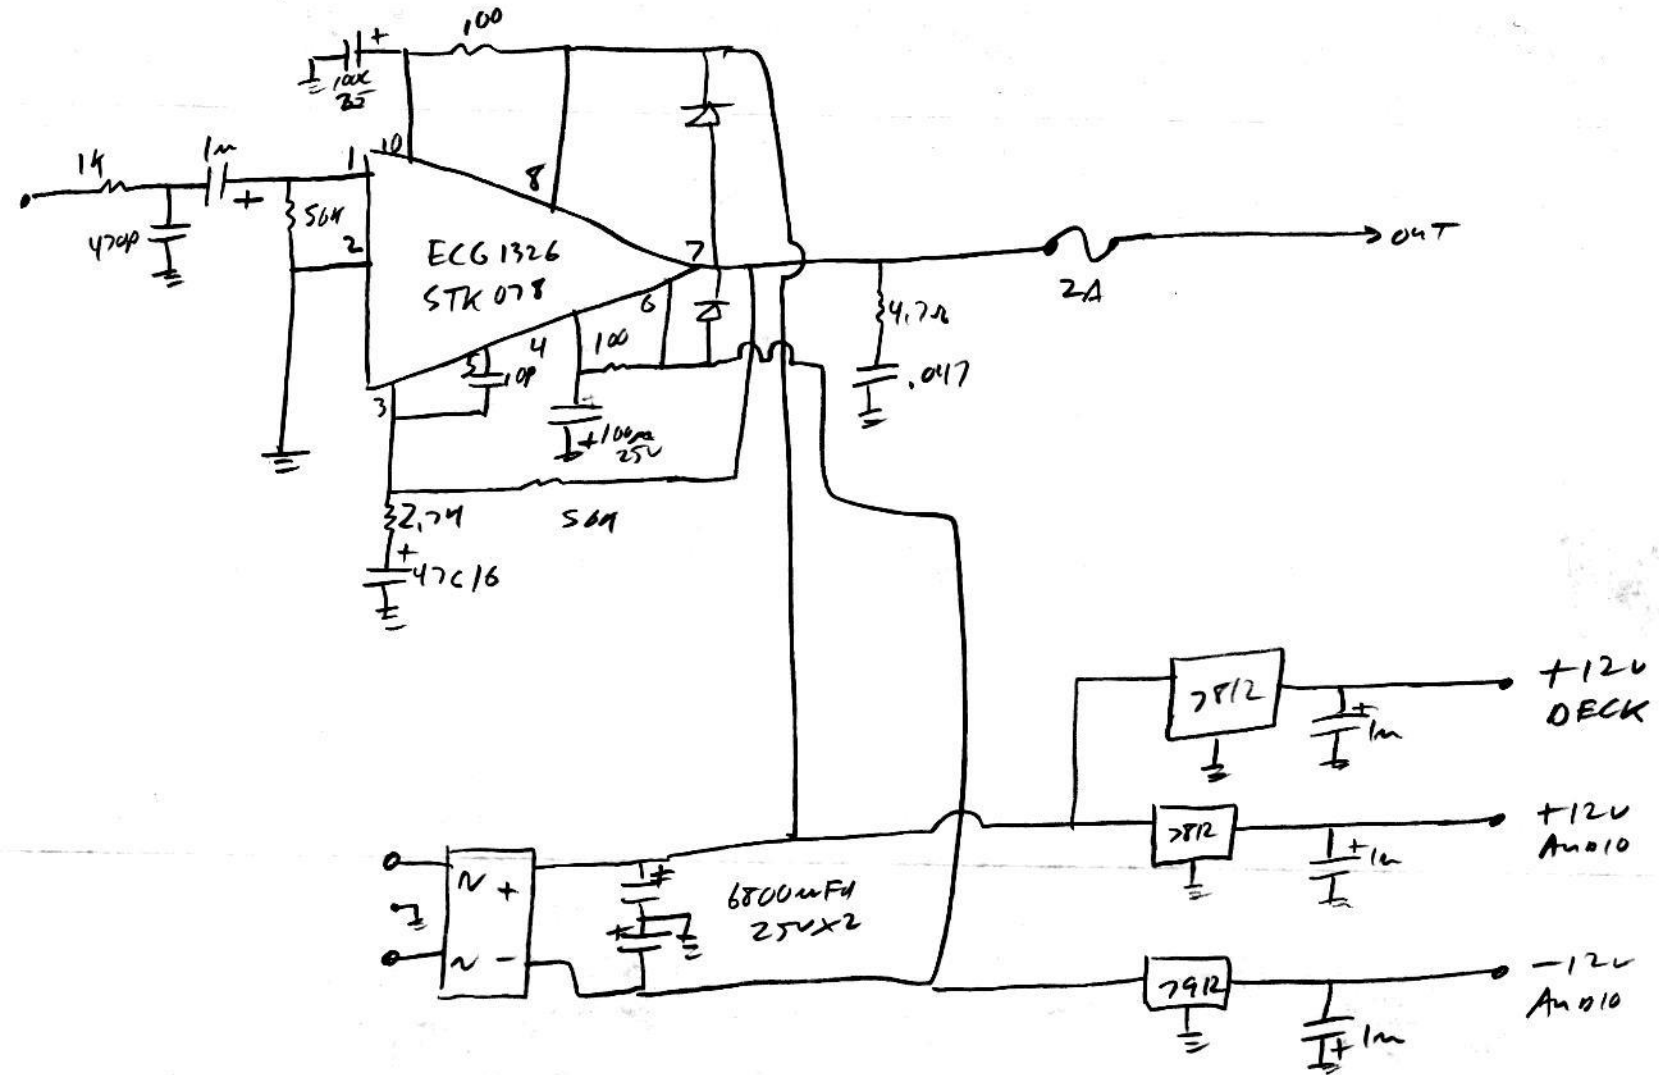


7-8-95

07

4 Grand Holodack V1.0

Tone Control / Anti-Thump Filter

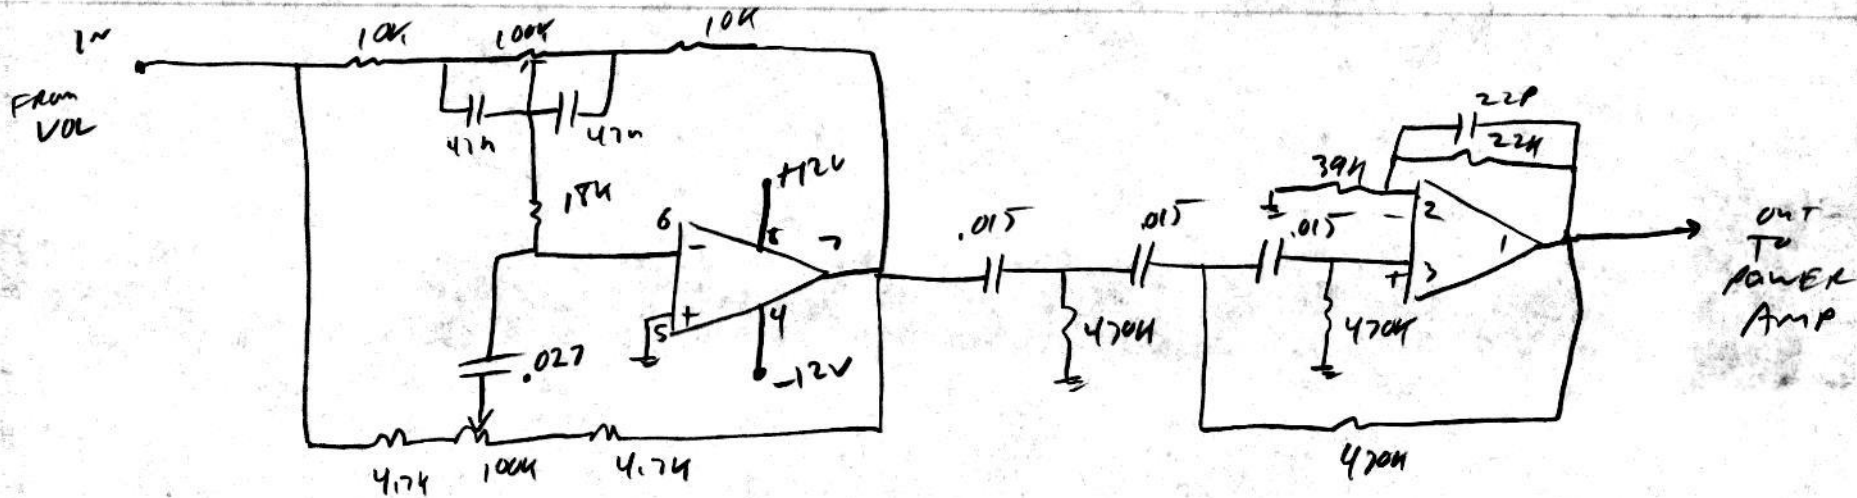


7-8-95

JF

4 Ground Holodeck V1.0

LED DISPLAY

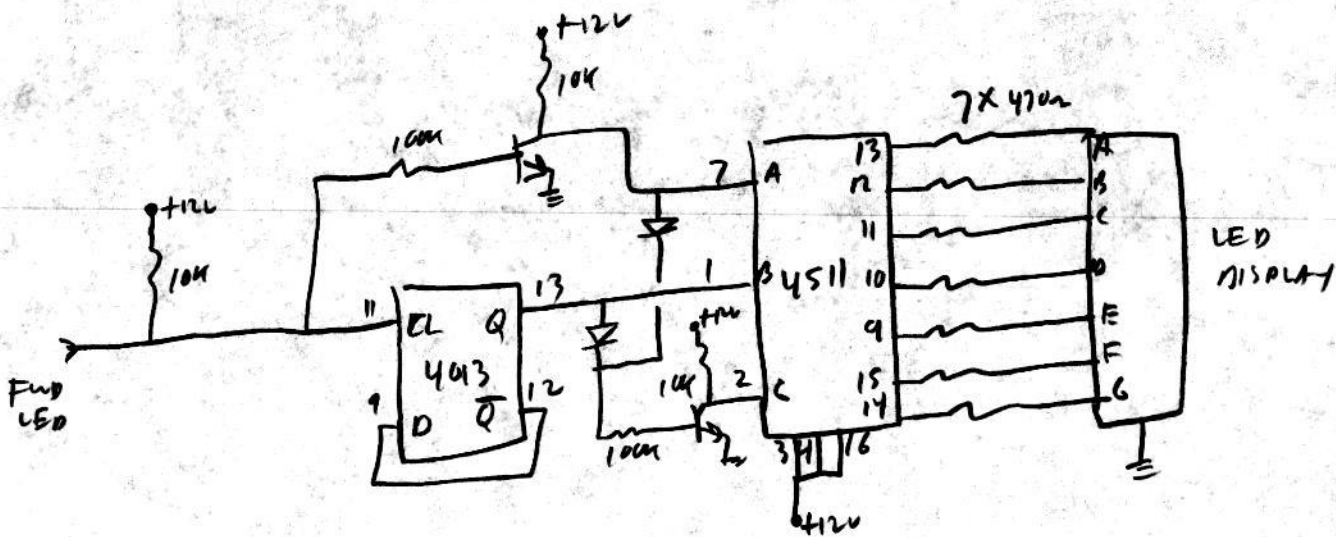

7-8-95

DT

4 Grand Holodeck V1.0